


FACILITIES MANAGEMENT

Saunders Building

PO Box 1700 STN CSC Victoria BC V8W 2Y2 Canada

Title:	Fraser Building (FRA) – Main Entrance Closure
Location:	Fraser Building
Description:	<p>The main entrance to the Fraser Building will be closed from June 3 to July 1 to facilitate construction activities on the NCIL project.</p> <p>The south entrance walkway will remain open and provide primary access/egress for the Fraser Building.</p> <p>The Law Library Stair 2 will provide secondary access for staff/faculty during the hours of 9am-4:30pm.</p> <p>Noisy work will occur at the main entrance for a period of 1 week. Staff working in the Level 1 office spaces will be impacted from June 3 - 7.</p> <p>The current bike racks will be relocated for the summer months. Please refer to the attached markup for location.</p> <p>Please follow directions of construction signage.</p>
Time frame:	Monday, June 3, 2024 – July 1, 2024
FMGT contacts:	Tristan Lowenberger, Project Manager
Email address:	tristanlowenberger@uvic.ca
Phone:	250-661-0599

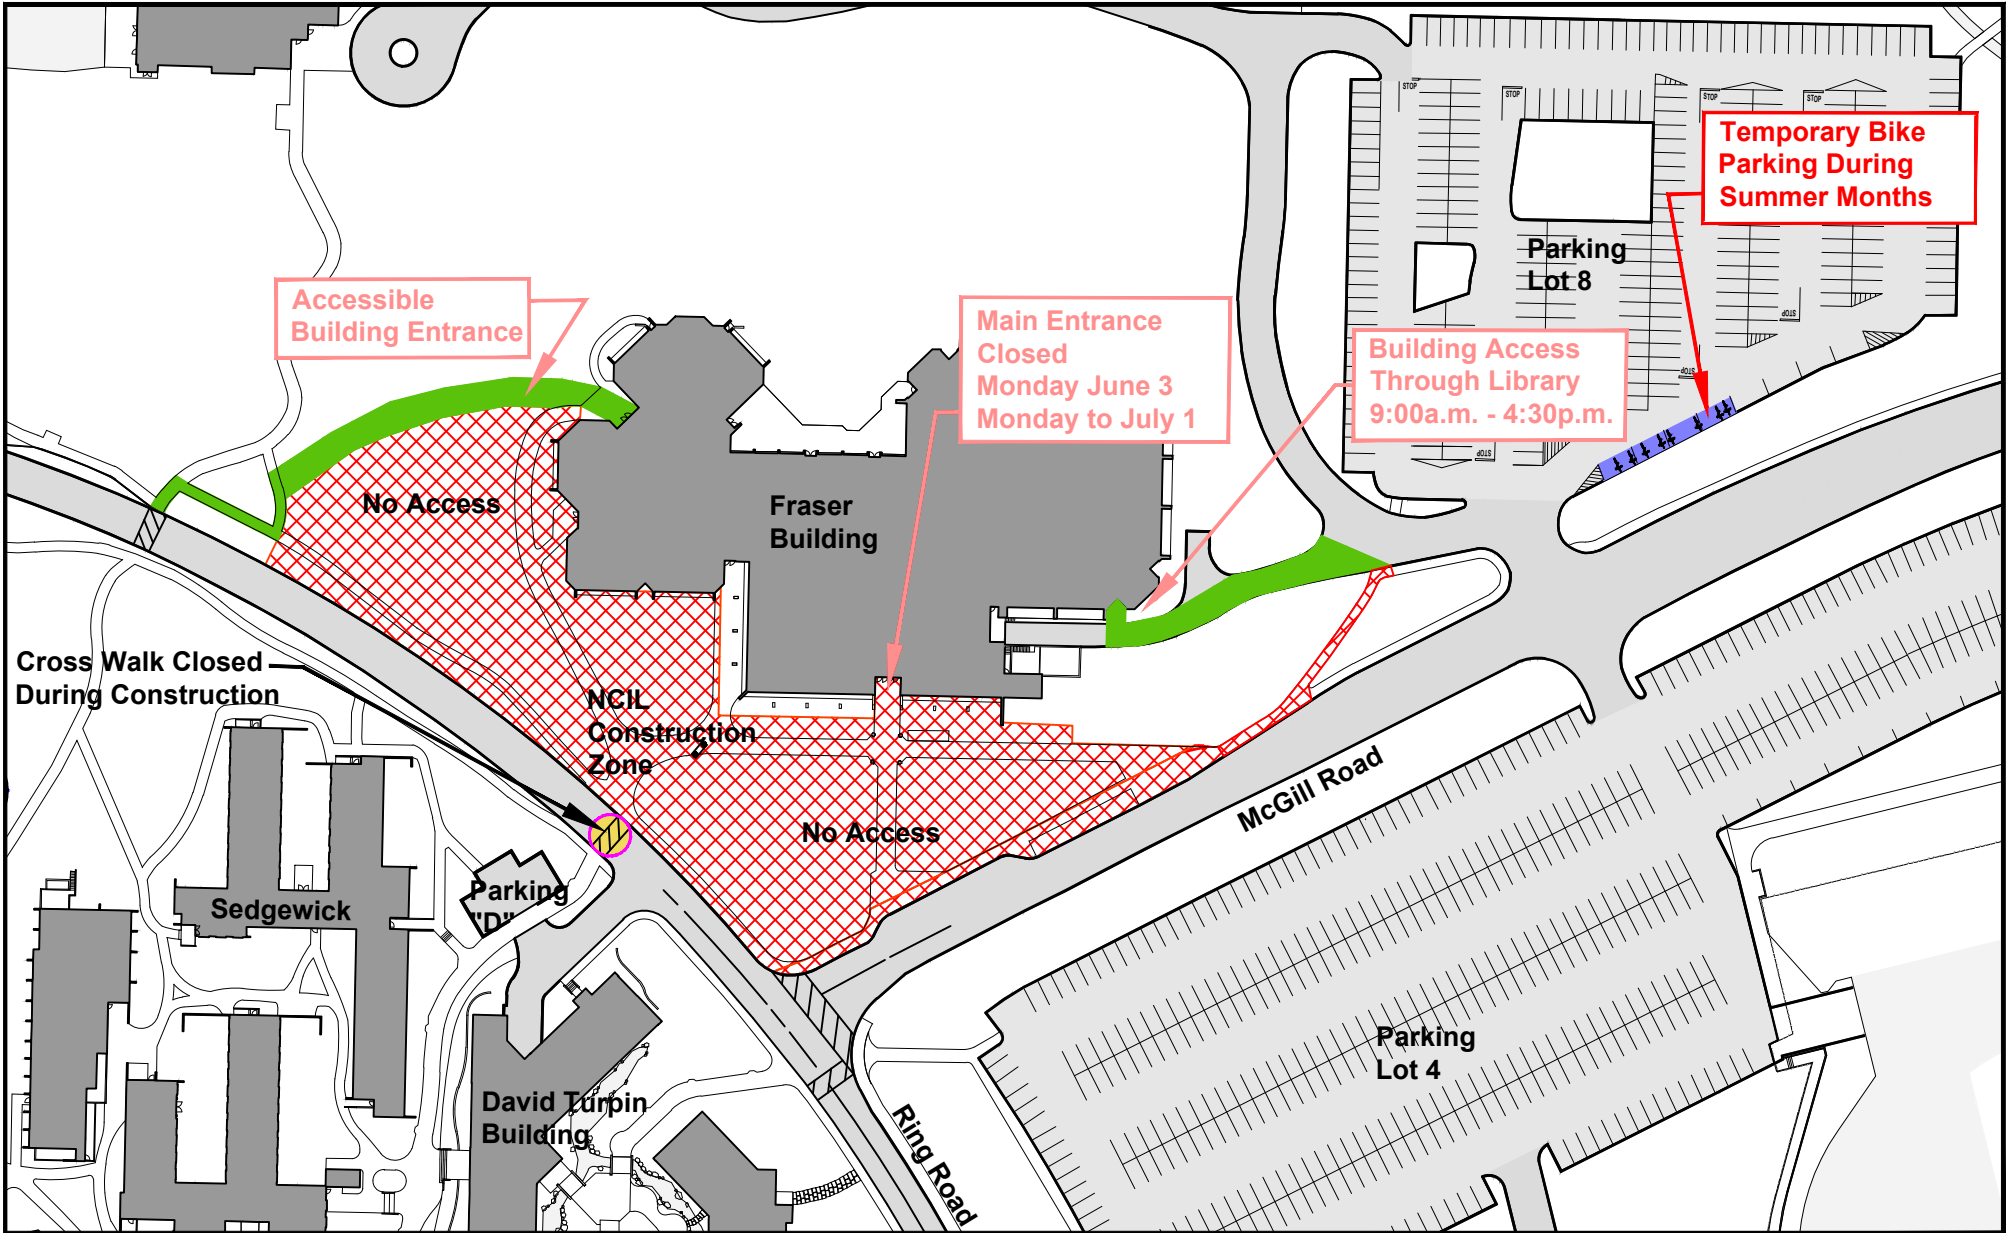

Notes:



**University
of Victoria**

Facilities Management

Title:
Fraser Building
Temporary Bike Parking

Date: May 31, 2024
 Scale: NTS
 Drawn By: djp
 Project Number: 20-04526
 Drawing No. SK - 1