


## FACILITIES MANAGEMENT

Saunders Building

PO Box 1700 STN CSC Victoria BC V8W 2Y2 Canada

---

<b>Title:</b>	Fraser Building (FRA) – National Centre for Indigenous Laws Bike Rack Relocation
<b>Location:</b>	Fraser Building – Ring Road/McGill Road
<b>Description:</b>	<p>The bike racks outside the Fraser Building will be relocated to accommodate construction on the National Centre for Indigenous Laws (NCIL) project.</p> <p>Select bike racks will remain near the Fraser building main entrance. The majority of bike racks will be relocated to the North along McGill Road for the duration of construction.</p> <p>Please refer to the attached markup below for more information.</p>
<b>Time frame:</b>	February 4, 2023 – Fall, 2024
<b>FMGT contacts:</b>	Tristan Lowenberger, Project Manager
<b>Email address:</b>	<a href="mailto:tristanlowenberger@uvic.ca">tristanlowenberger@uvic.ca</a>
<b>Phone:</b>	250-661-0599

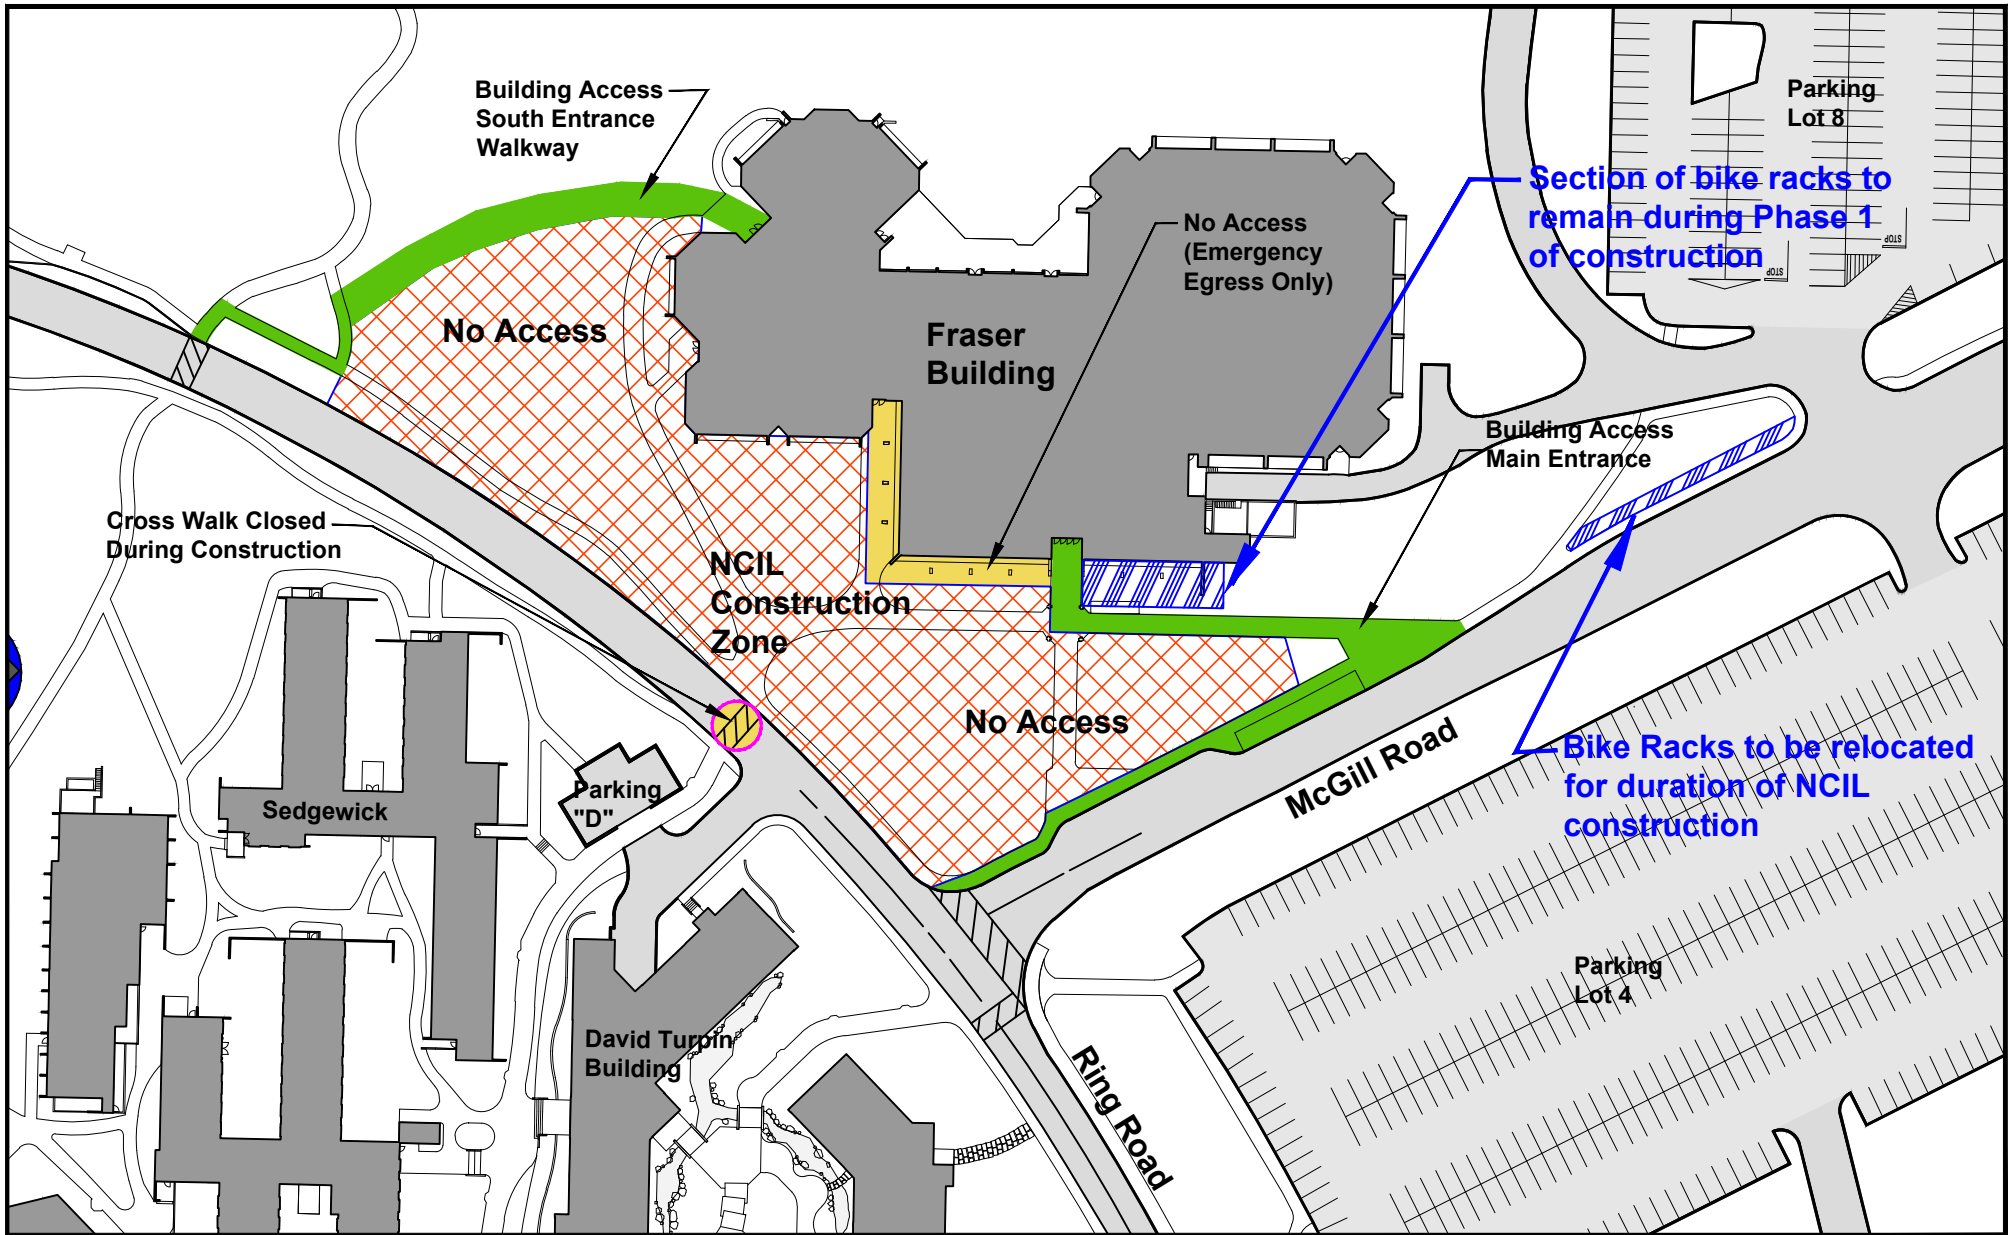

Notes:



**University  
of Victoria**

Facilities Management

Title:

Fraser Building  
Bike Rack Relocation

Date:

Feb 3, 2023

Scale:

NTS

Drawn By:

djp

Project Number:

19-04343

Drawing No.

SK - 1