


FACILITIES MANAGEMENT

Saunders Building

PO Box 1700 STN CSC Victoria BC V8W 2Y2 Canada

Title:	McGill Road Closure
Location:	Fraser Building – Ring Road / McGill Road
Description:	<p>A section of McGill Road will be closed to vehicle traffic to facilitate construction activities on the National Centre for Indigenous Laws (NCIL) project.</p> <p>Vehicle traffic will be diverted through Parking Lot #4.</p> <p>A walking path will be created on McGill Road to allow pedestrian access.</p> <p>Please refer to the markup below which identifies access changes.</p> <p>Please follow directions of Traffic Control personnel and construction signage.</p>
Time frame:	March 14, 2023 – March 17, 2023 from 7:00 am – 4:00 pm
FMGT contacts:	Tristan Lowenberger, Project Manager
Email address:	tristanlowenberger@uvic.ca
Phone:	250-661-0599



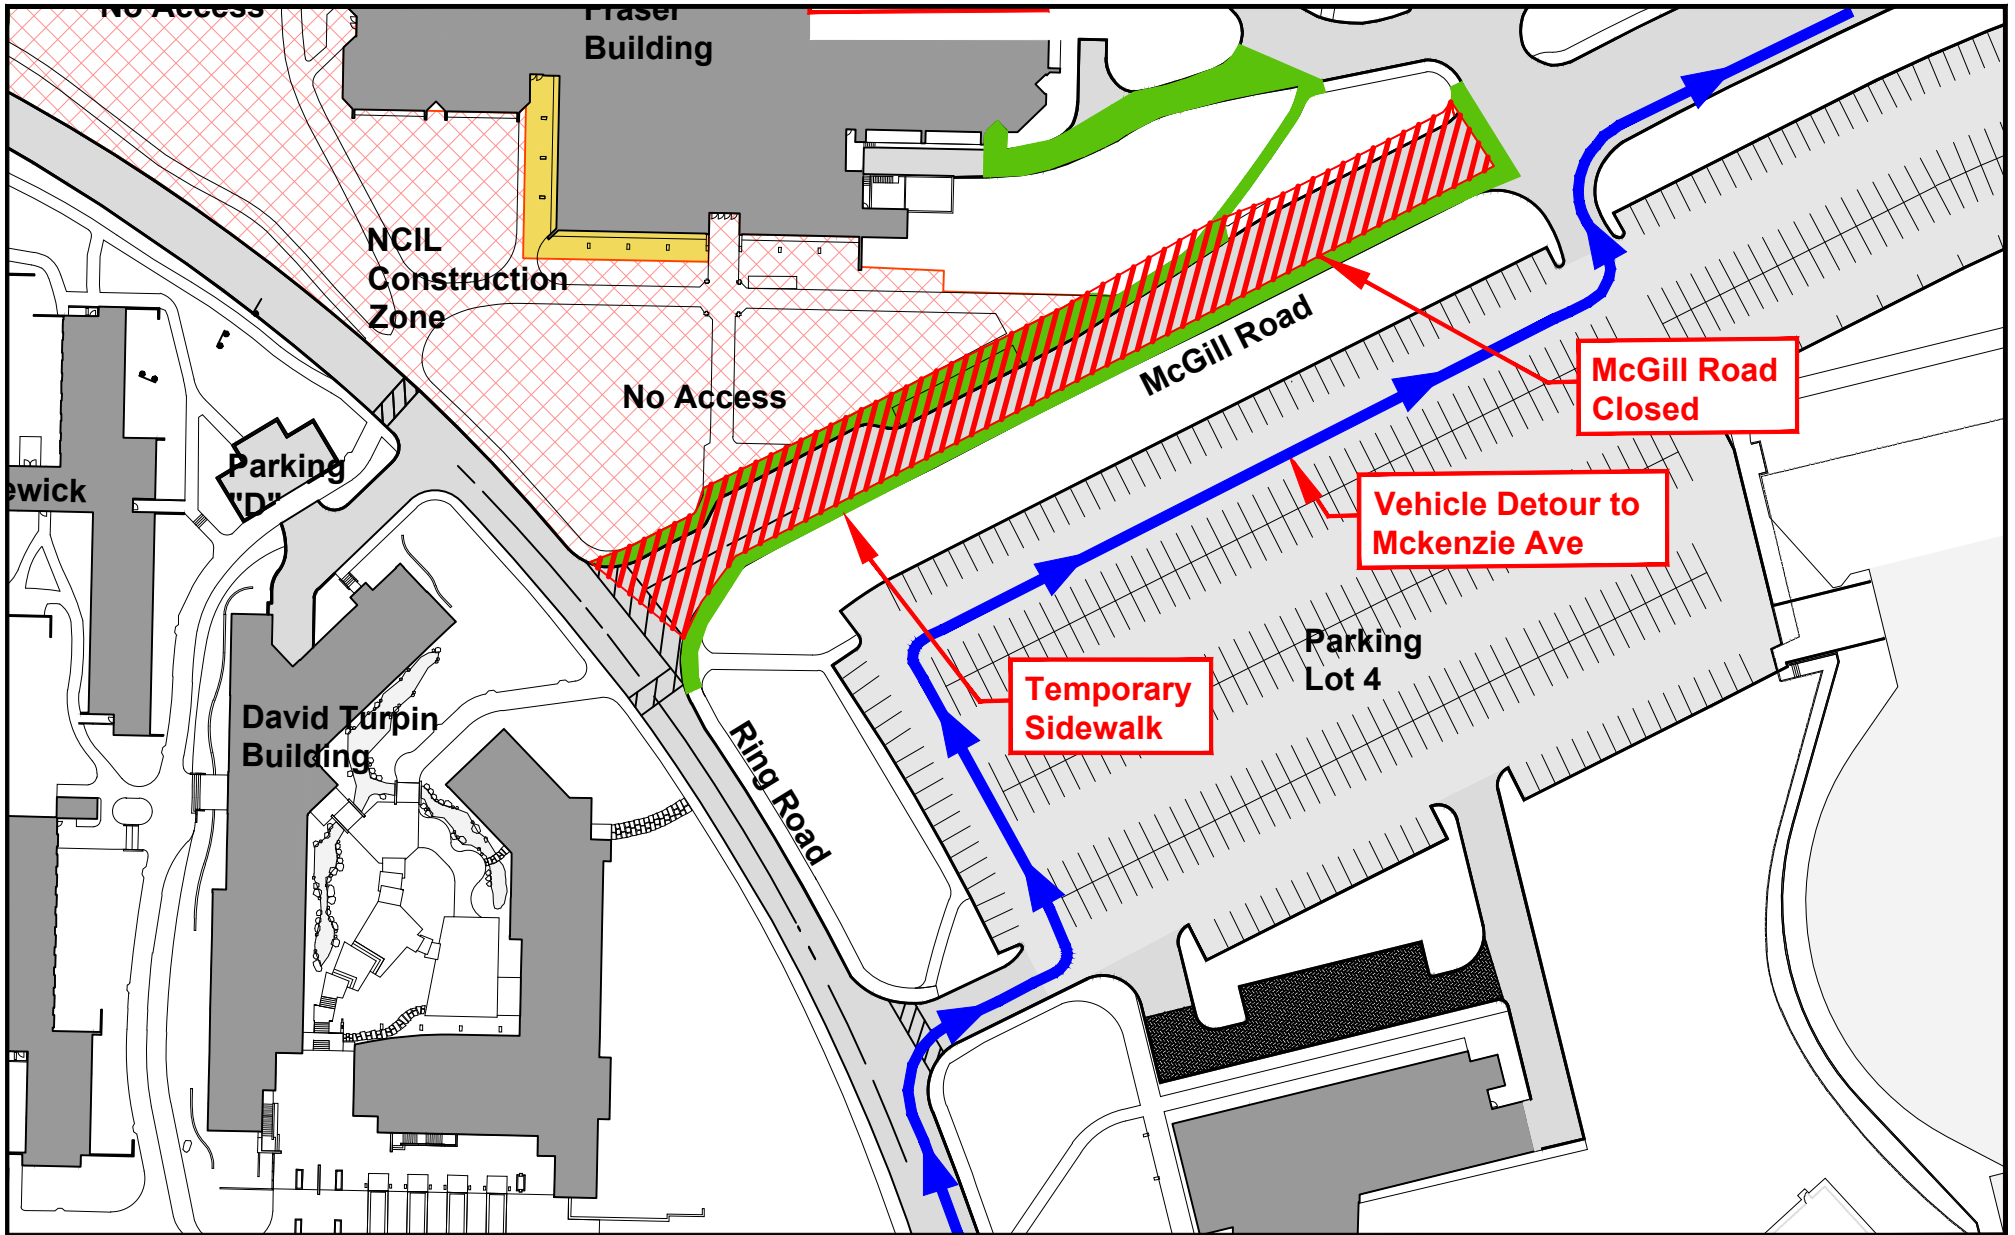

Notes:



**University
of Victoria**

Facilities Management

Title:

Fraser Building
McGil Road Closure
Detour

Date:

March 13, 2023

Scale:

NTS

Drawn By:

djp

Project Number:

19-04343

Drawing No.

SK - 1